

BY	
REVISION	
DATE	
NO.	

SEAL

PROJECT
WEQUASSETT RESORT AND GOLF CLUB
2171 ROUTE 28
HARWICH, MA

SHEET TITLE
WASTEWATER TREATMENT FACILITY AS-BUILT

SCALE
AS NOTED

DRAWING FILE
C1654203-MASTER-CONST.dwg

DATE
03-19-09


DRAWN BY
TLM

CHECKED BY

C1.4.1

1 OF 2 SHEETS

PROJECT NO.
C16542.03

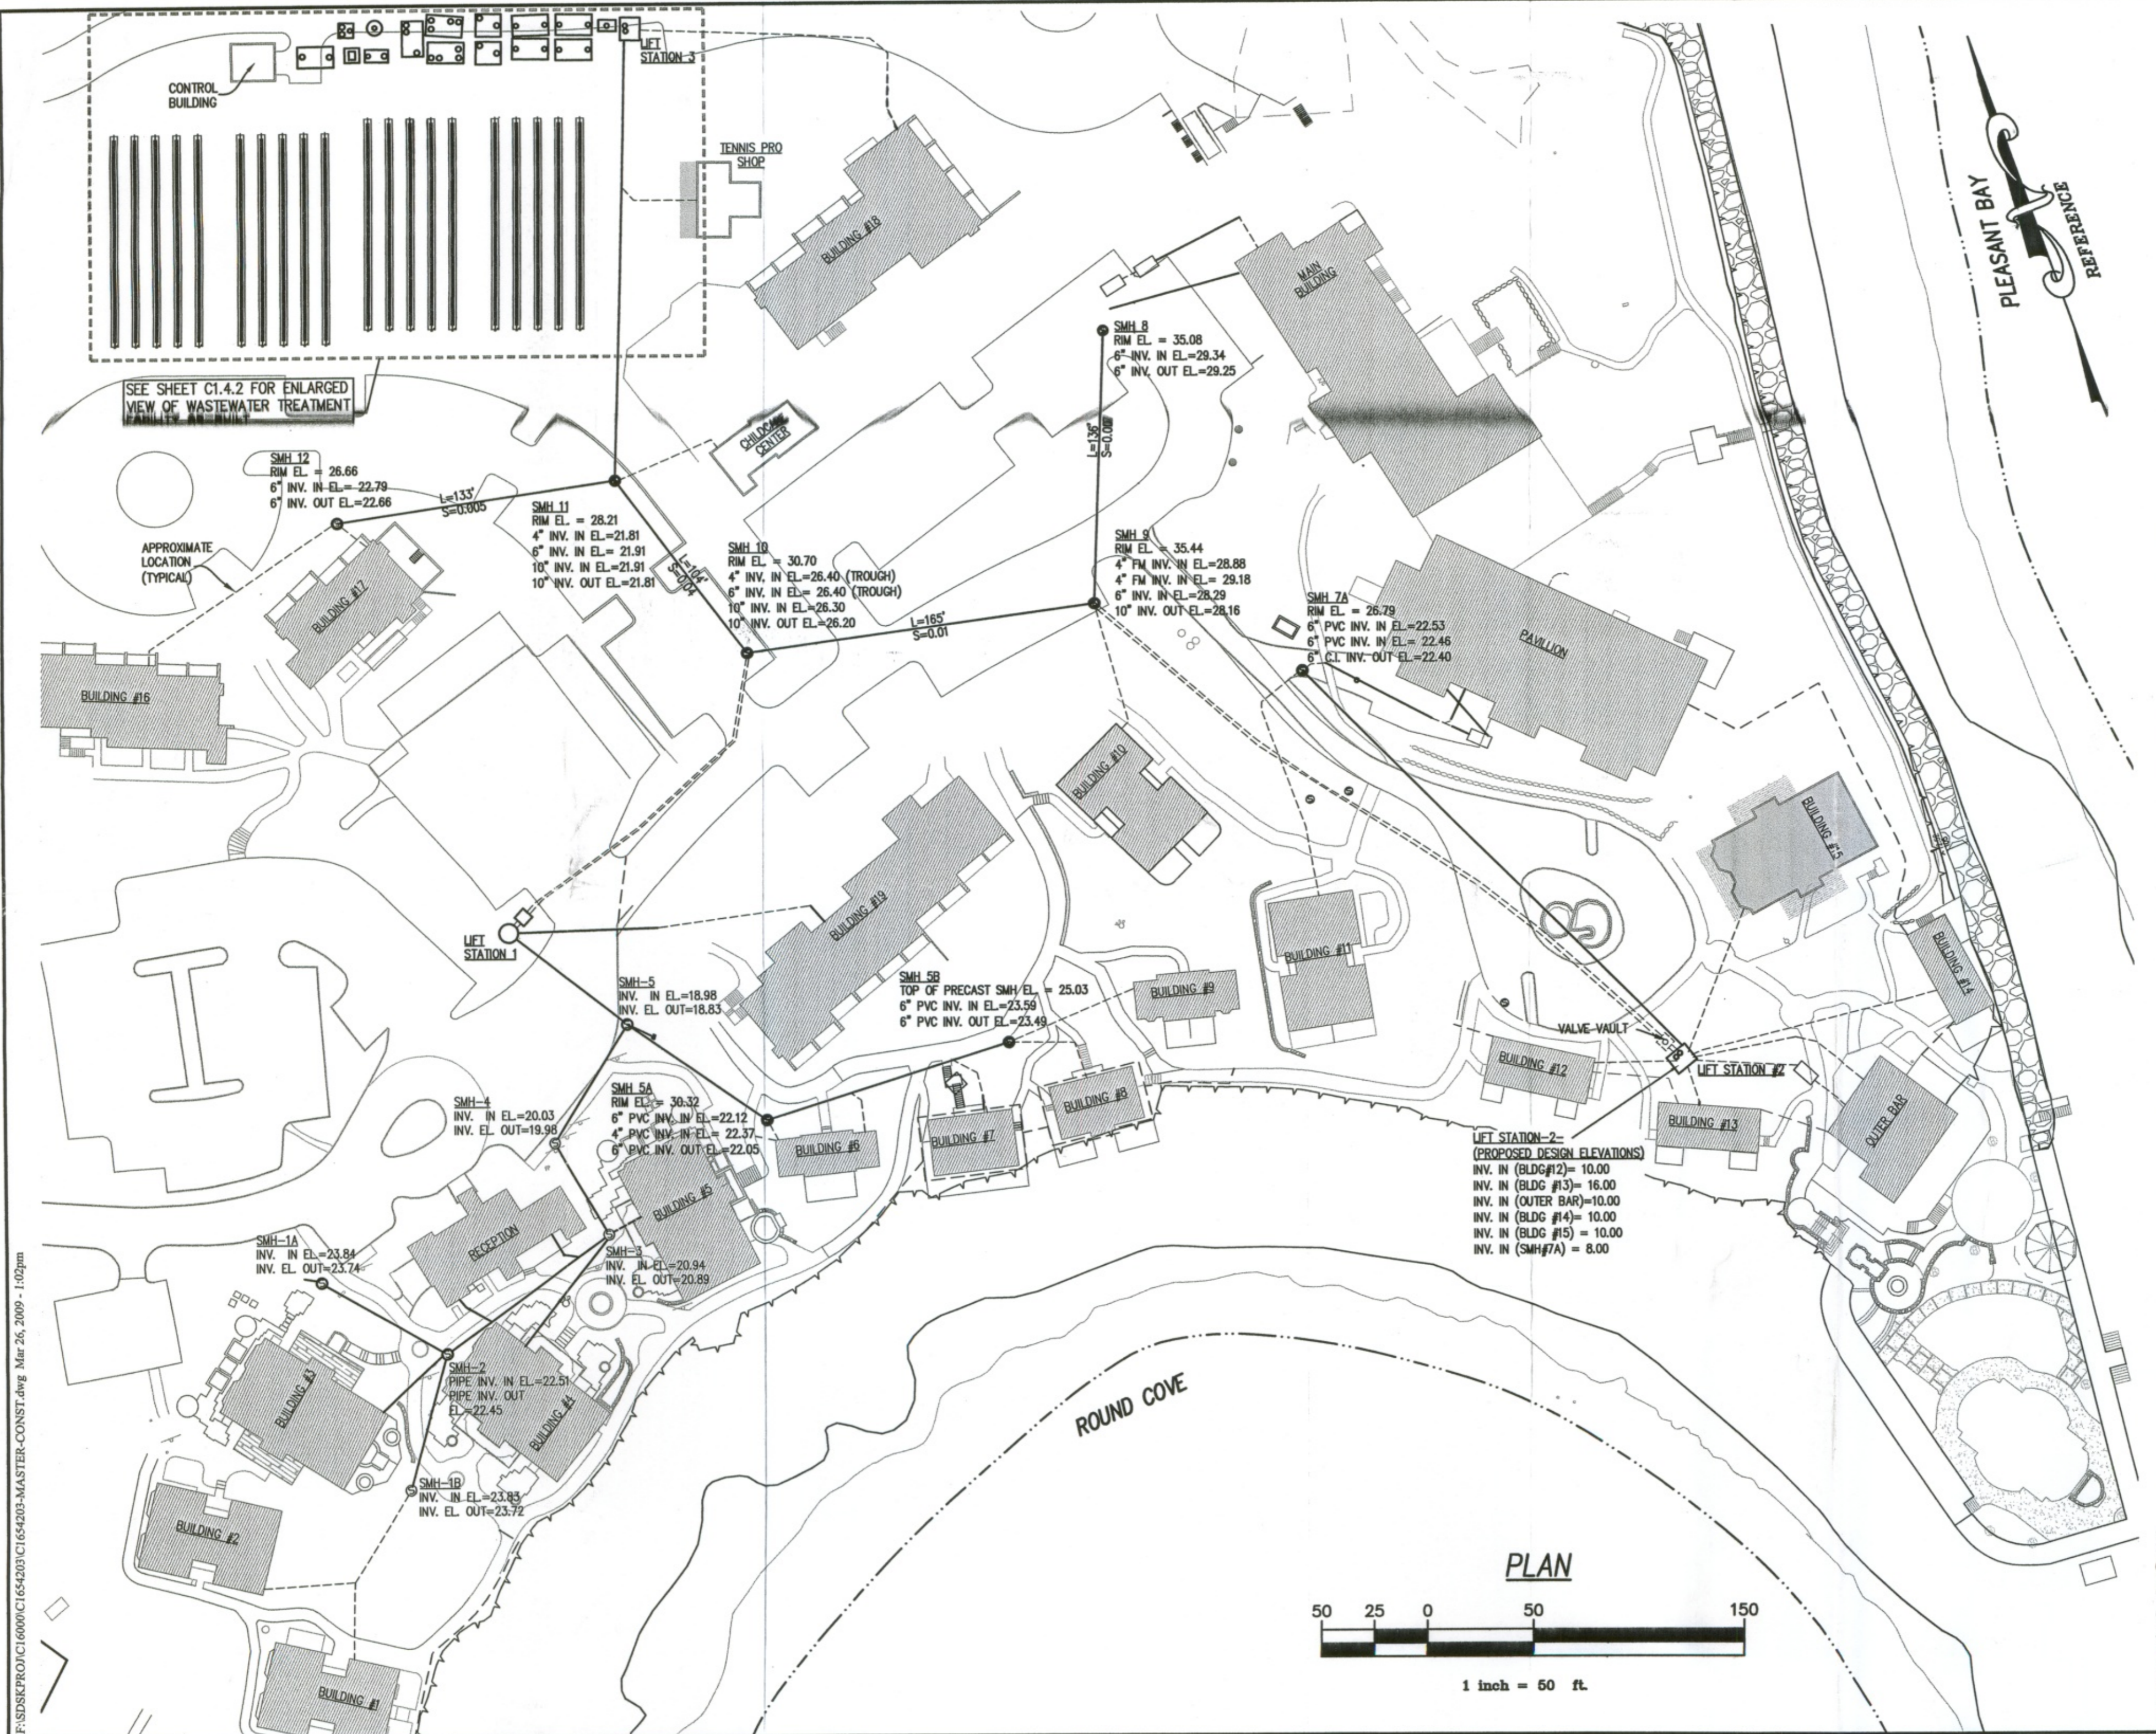

F:\SDSK\PROJ\16000\C1654203\C1654203-MASTER-CONST.dwg Mar 26, 2009 - 1:07pm